



CLIENT


XXXXXXX  
XXXX X XXXX XXX  
XXX XXXXX, XX XXXXX  
XXXX XXXXX  
OFFICE:  
EMAIL:

CONSULTANT

ESCALAD AS-BUILT | DESIGN  
2148 GAVIOTA AVE  
SIGNAL HILL, CA 90755  
VICTOR  
OFFICE: 562-507-3319  
EMAIL: VARVIZU@ESCALADESIGNASBUILT.COM

PROJECT

2031 Pelham Ave  
2031 PELHAM AVE.  
WEST LOS ANGELES, CA 90025

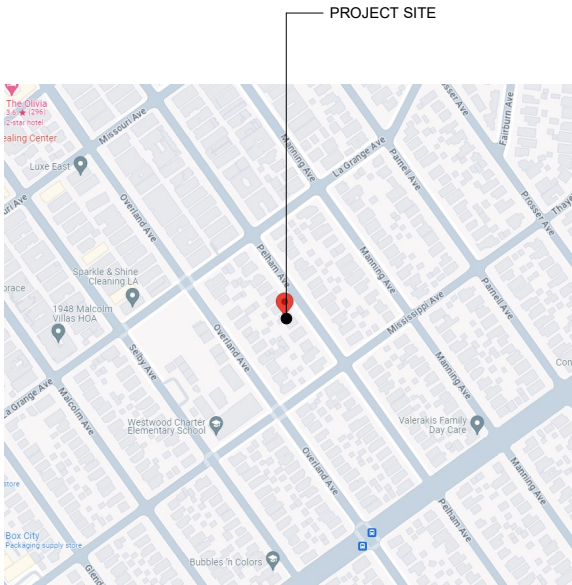

Project Owner:

Consultant:



2148 Gaviota Ave,  
Signal Hill, CA 90755  
(562) 507-3319  
varvizu@escaladesignasbuilt.com

Plans, maps, specifications, studies and reports not containing a red ink seal imprint accompanied by an original signature by the licensed professional may have been fraudulently altered and shall not be considered an original copy. All information should be disregarded unless verified by the professional whose signature appears below

Copyright protected 2022


Project Address:

2031 Pelham Ave

PROJECT PHOTO

PROJECT DIRECTORY

VICINITY MAP

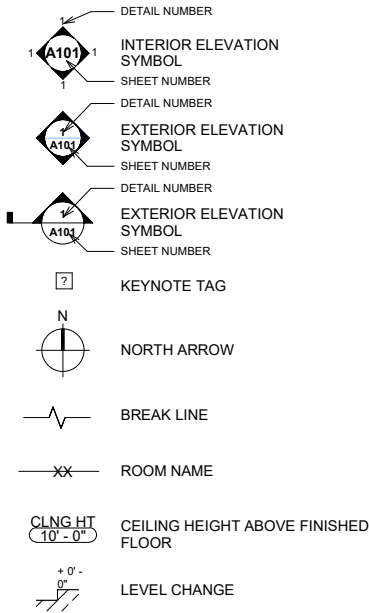

ABV	ABOVE	ABV	ABOVE
ACT	ACOUSTICAL CEILING TILE	ACT	ACOUSTICAL CEILING TILE
ADA	AMERICAN DISABILITIES ACT	ADA	AMERICAN DISABILITIES ACT
AFF	ABOVE FINISH FLOOR	AFF	ABOVE FINISH FLOOR
AHU	AIR HANDLER UNIT	AHU	AIR HANDLER UNIT
BD	BOARD	BD	BOARD
BLDG	BUILDING	BLDG	BUILDING
BOT	BOTTOM	BOT	BOTTOM
CL	CENTER LINE	CL	CENTER LINE
CLG	CEILING	CLG	CEILING
CMU	CONCRETE MASONRY UNIT	CMU	CONCRETE MASONRY UNIT
CO	CLEANOUT	CO	CLEANOUT
COL	COLUMN	COL	COLUMN
CONC	CONCRETE	CONC	CONCRETE
DTL	DETAIL	DTL	DETAIL
DIA	DIAMETER	DIA	DIAMETER
DN	DOWN	DN	DOWN
EA	EACH	EA	EACH
EL	ELEVATION	EL	ELEVATION
ELEC	ELECTRICAL	ELEC	ELECTRICAL
ELEV	ELEVATOR	ELEV	ELEVATOR
EMER	EMERGENCY	EMER	EMERGENCY
EQ	EQUAL	EQ	EQUAL
EQPT	EQUIPMENT	EQPT	EQUIPMENT
EXIST	EXISTING	EXIST	EXISTING
EXT	EXTERIOR	EXT	EXTERIOR
FDC	FIRE DEPARTMENT CONNECTION	FDC	FIRE DEPARTMENT CONNECTION
FE	FIRE EXTINGUISHER	FE	FIRE EXTINGUISHER
FT	FEET	FT	FEET
GW/B	GYPSON WALL BOARD	GW/B	GYPSON WALL BOARD
GYP	GYPSON	GYP	GYPSON
HB	HOSE BIB	HB	HOSE BIB
HT	HEIGHT	HT	HEIGHT
HORIZ	HORIZONTAL	HORIZ	HORIZONTAL
HVAC	HEATING, VENTING & AIR COND	HVAC	HEATING, VENTING & AIR COND
IN	INCH	IN	INCH
INT	INTERIOR	INT	INTERIOR
JBOX	JUNCTION BOX	JBOX	JUNCTION BOX
JAN	JANITOR	JAN	JANITOR
LAV	LAVATORY	LAV	LAVATORY
LH	LEFT HAND	LH	LEFT HAND

SHEET	DESCRIPTION	REVISION
A1	COVER SHEET	
A2	GROUND LEVEL	
A3	LEVEL 1-DOOR-WINDOWS	
A4	ATTIC LEVEL	
A5	GROUND RCP	
A6	EXTERIOR ELEVATIONS	
A7	EXTERIOR ELEVATION	
A8	3D VIEW	
A9	3D PLAN VIEW	

Stamp:

No.	DATE	DESCRIPTION

Sheet Title:

COVER SHEET



DRAWN BY: Author
DRAWING DATE: 7.11.24
REVIEWED BY: VA
PROJECT NUMBER:Project Number
TEMPLATE TYPE:
SHEET

SYMBOL LEGEND

ABBREVIATIONS

SHEET INDEX

A1

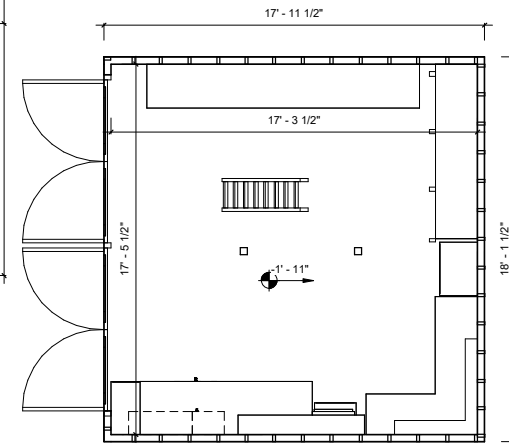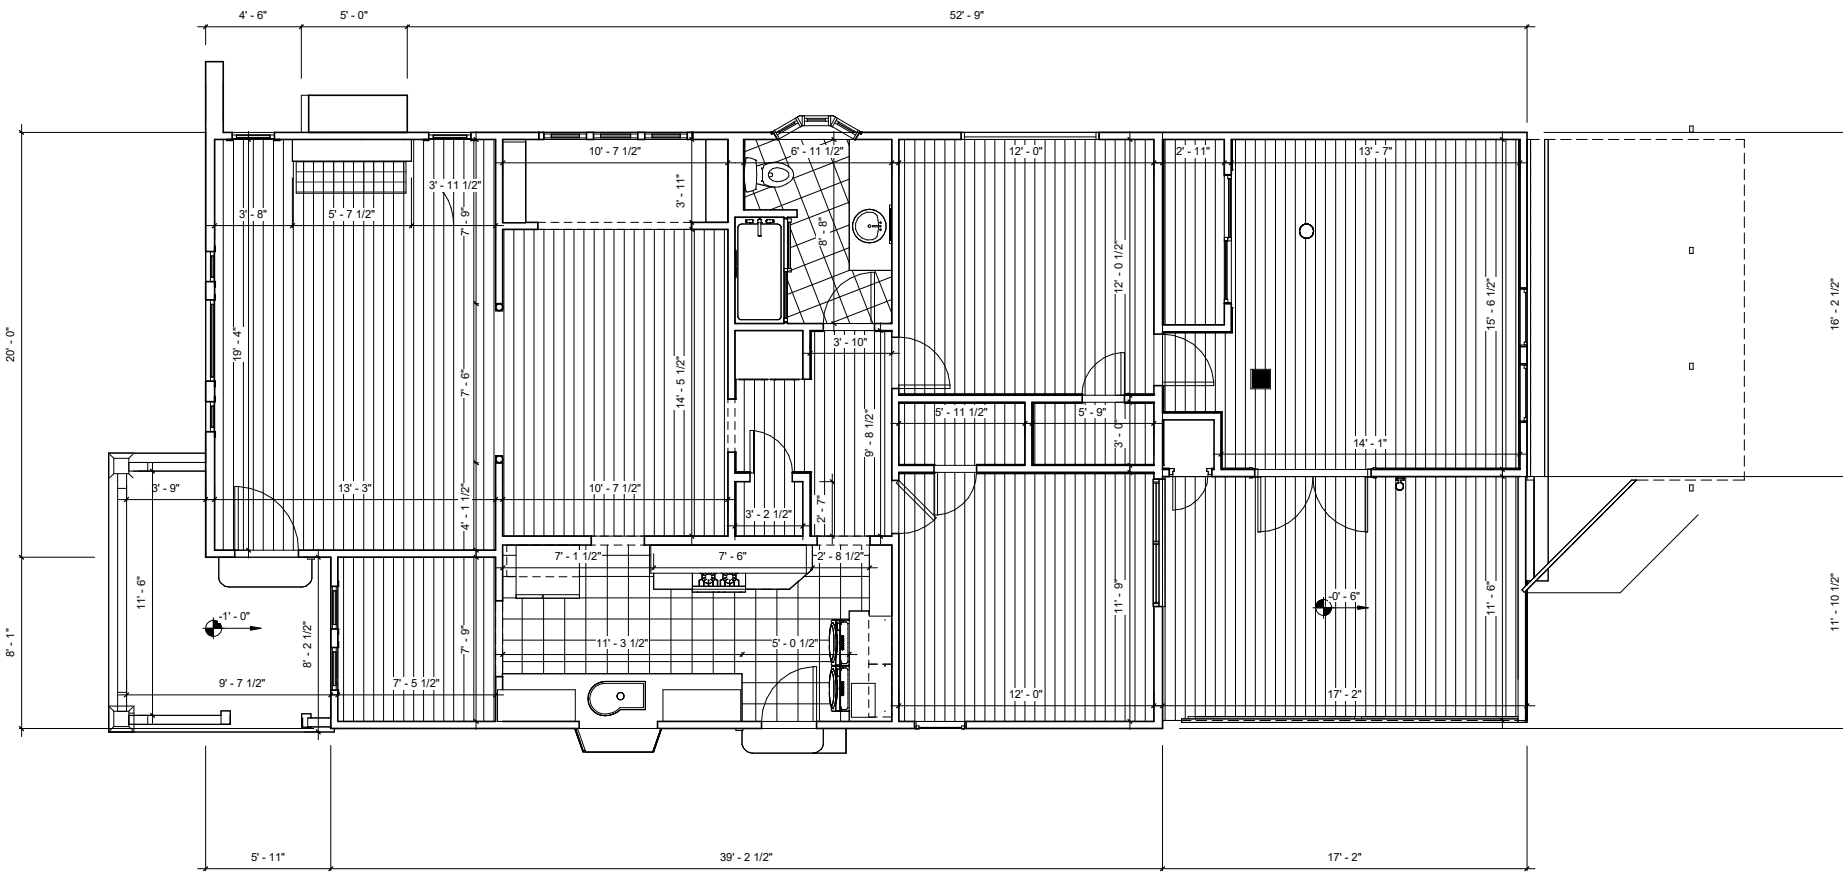

Project Owner:

Consultant:



2148 Gaviota Ave,  
Signal Hill, CA 90755  
(562) 507-3319  
varvizu@escaladesignsbuilt.com

Plans, maps, specifications, studies and reports not containing a red ink seal imprint accompanied by an original signature by the licensed professional may have been fraudulently altered and shall not be considered an original copy. All information should be disregarded unless verified by the professional whose signature appears below

Copyright protected 2022

Project Address:

2031 Pelham Ave

Stamp:



DATE	DESCRIPTION

Sheet Title:

GROUND  
LEVEL

DRAWN BY: Author
DRAWING DATE: 7.11.24
REVIEWED BY: VA
PROJECT NUMBER: Project Number
TEMPLATE TYPE:
SHEET

A2

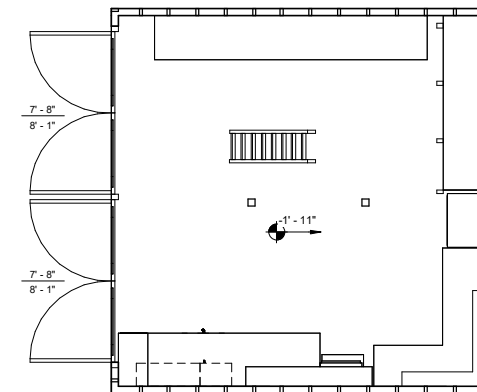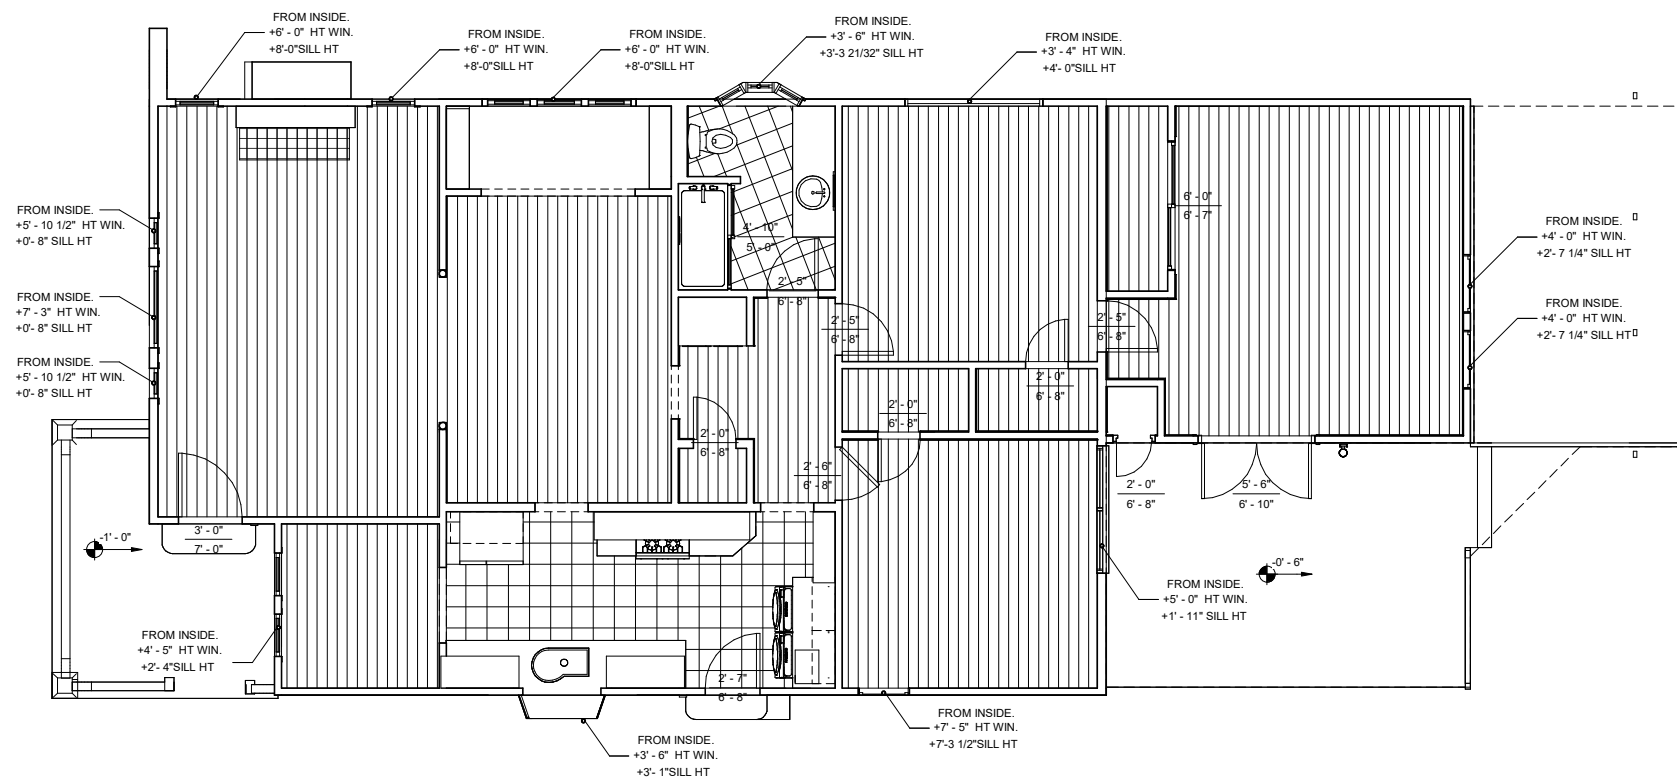

Project Owner:

Consultant:



2148 Gaviota Ave,  
Signal Hill, CA 90755  
(562) 507-3319  
varvizu@escaladesignsbuilt.com

Plans, maps, specifications, studies and reports not containing a red ink seal imprint accompanied by an original signature by the licensed professional may have been fraudulently altered and shall not be considered an original copy. All information should be disregarded unless verified by the professional whose signature appears below

Copyright protected 2022

Project Address:

2031 Pelham Ave


Stamp:

DATE	DESCRIPTION

Sheet Title:  
LEVEL  
1-DOOR-WINDOWS

DRAWN BY: Author  
DRAWING DATE: 7.11.24  
REVIEWED BY: VA  
PROJECT NUMBER: Project Number  
TEMPLATE TYPE:  
SHEET

A3

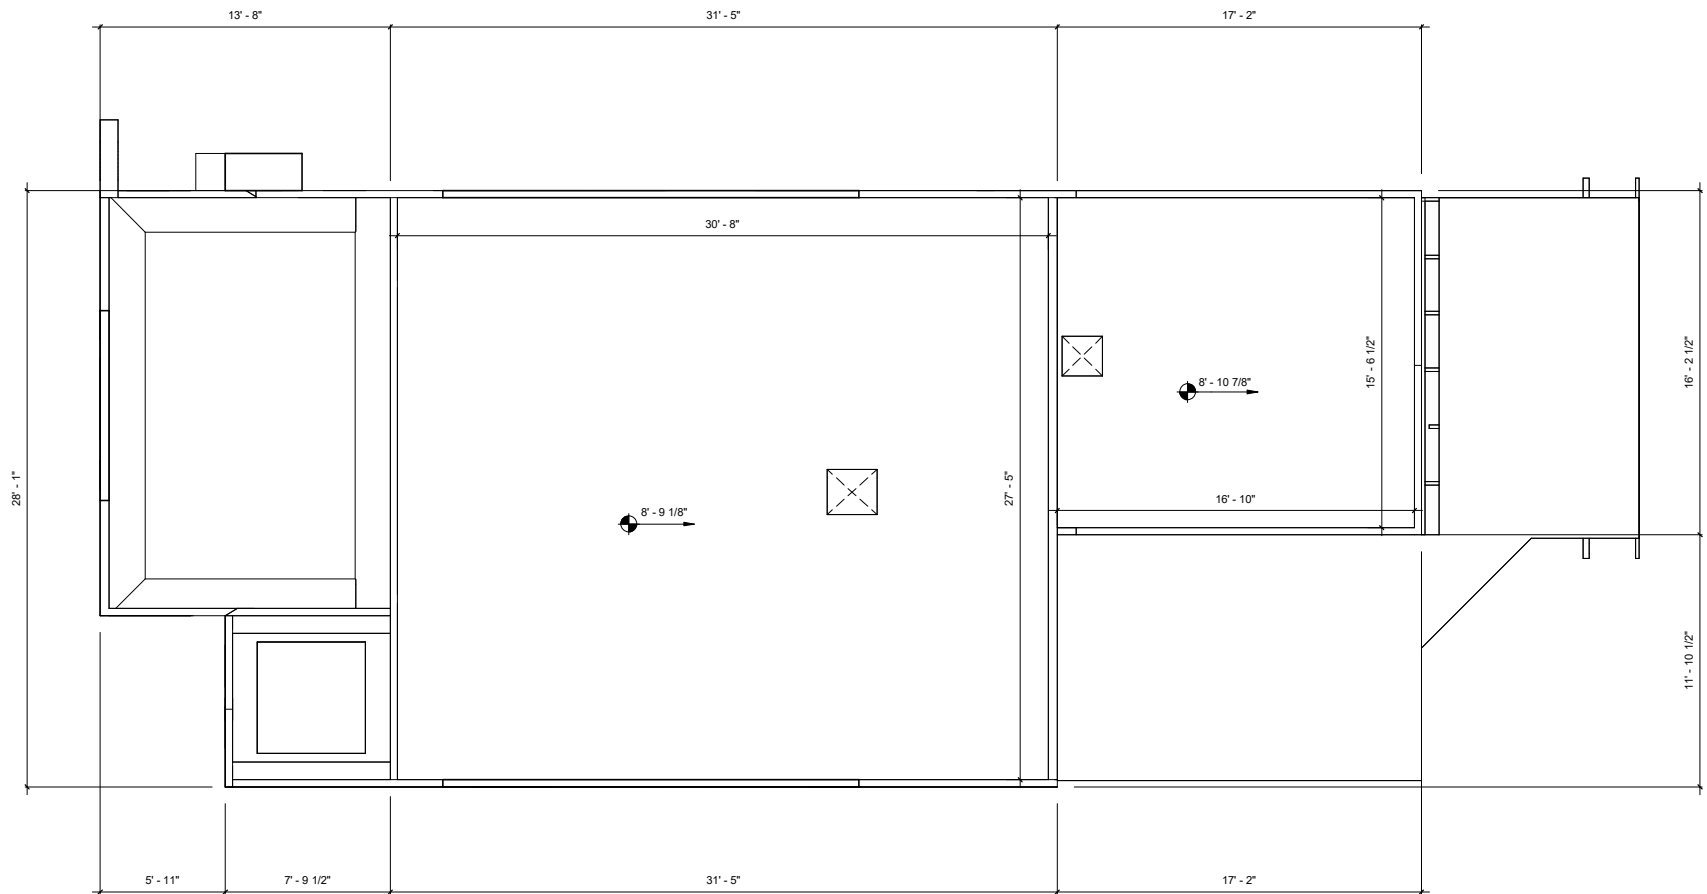

Project Owner:

Consultant:



2148 Gaviota Ave,  
Signal Hill, CA 90755  
(562) 507-3319  
varvizu@escaladesignasbuilt.com

Plans, maps, specifications, studies and reports not containing a red ink seal imprint accompanied by an original signature by the licensed professional may have been fraudulently altered and shall not be considered an original copy. All information should be disregarded unless verified by the professional whose signature appears below

Copyright protected 2022

Project Address:

2031 Pelham Ave

Stamp:



DATE	DESCRIPTION

Sheet Title:

ATTIC  
LEVEL

DRAWN BY: Author  
DRAWING DATE: 7.11.24  
REVIEWED BY: VA  
PROJECT NUMBER:Project Number  
TEMPLATE TYPE:  
SHEET

A4

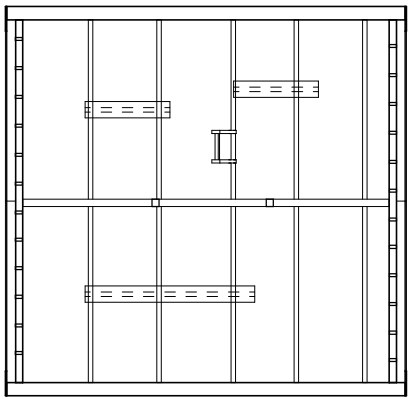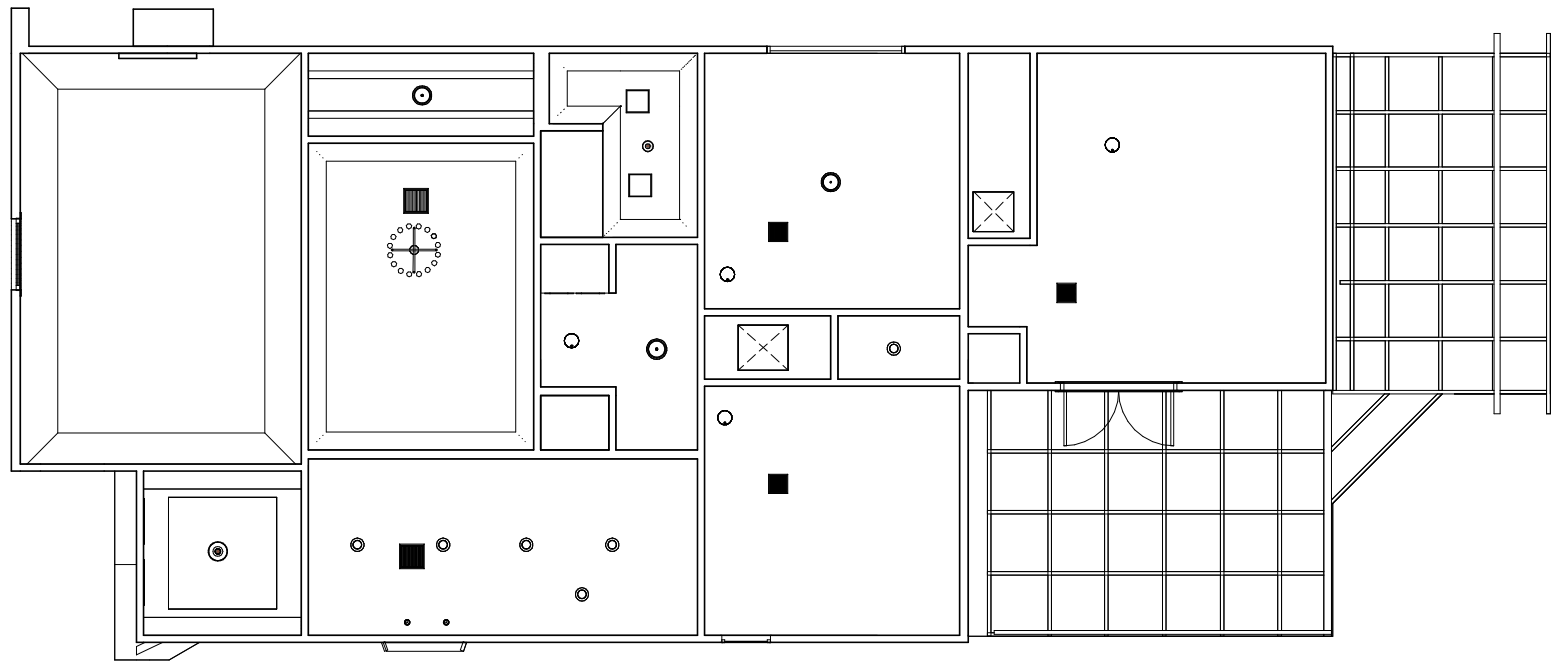

Project Owner:

Consultant:



2148 Gaviota Ave,  
Signal Hill, CA 90755  
(562) 507-3319  
varvizu@escaladesignasbuilt.com

Plans, maps, specifications, studies and reports not containing a red ink seal imprint accompanied by an original signature by the licensed professional may have been fraudulently altered and shall not be considered an original copy. All information should be disregarded unless verified by the professional whose signature appears below

Copyright protected 2022

Project Address:

2031 Pelham Ave



Stamp:

DATE	DESCRIPTION

Sheet Title:  
GROUND  
RCP

DRAWN BY: Author  
DRAWING DATE: 7.11.24  
REVIEWED BY: VA  
PROJECT NUMBER:Project Number  
TEMPLATE TYPE:  
SHEET

A5

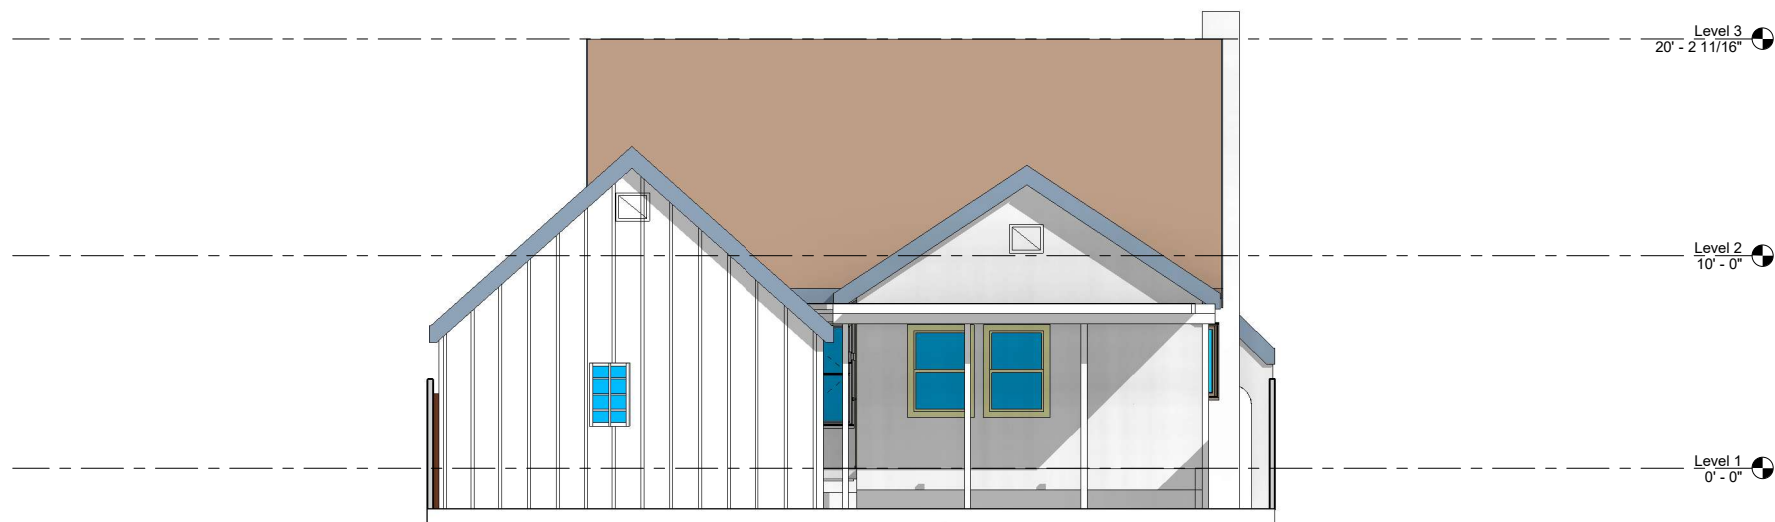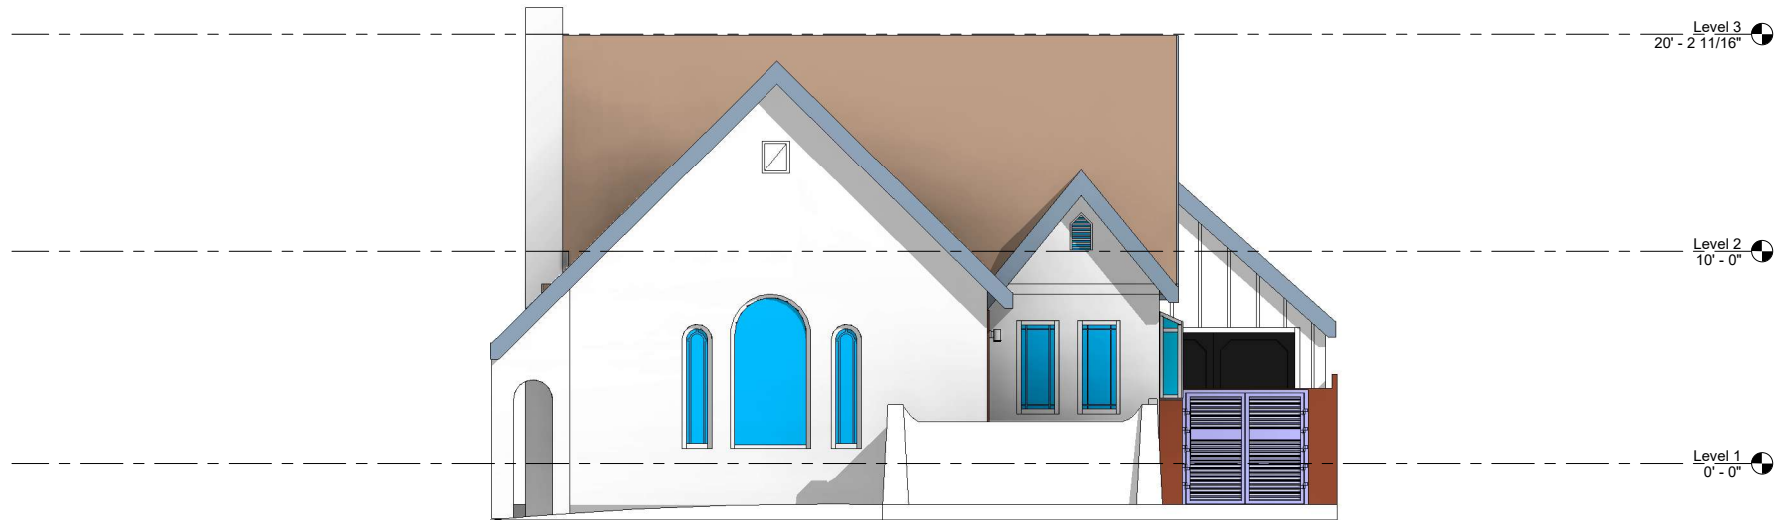

Project Owner:

Consultant:



2148 Gaviota Ave,  
Signal Hill, CA 90755  
(562) 507-3319  
varvizu@escaladesignsbuilt.com

Plans, maps, specifications, studies and reports not containing a red ink seal imprint accompanied by an original signature by the licensed professional may have been fraudulently altered and shall not be considered an original copy. All information should be disregarded unless verified by the professional whose signature appears below

Copyright protected 2022

Project Address:

2031 Pelham Ave

Stamp:



DATE	DESCRIPTION

Sheet Title:

EXTERIOR  
ELEVATIONS

DRAWN BY: Author  
DRAWING DATE: 7.11.24  
REVIEWED BY: VA  
PROJECT NUMBER: Project Number  
TEMPLATE TYPE:  
SHEET

A6

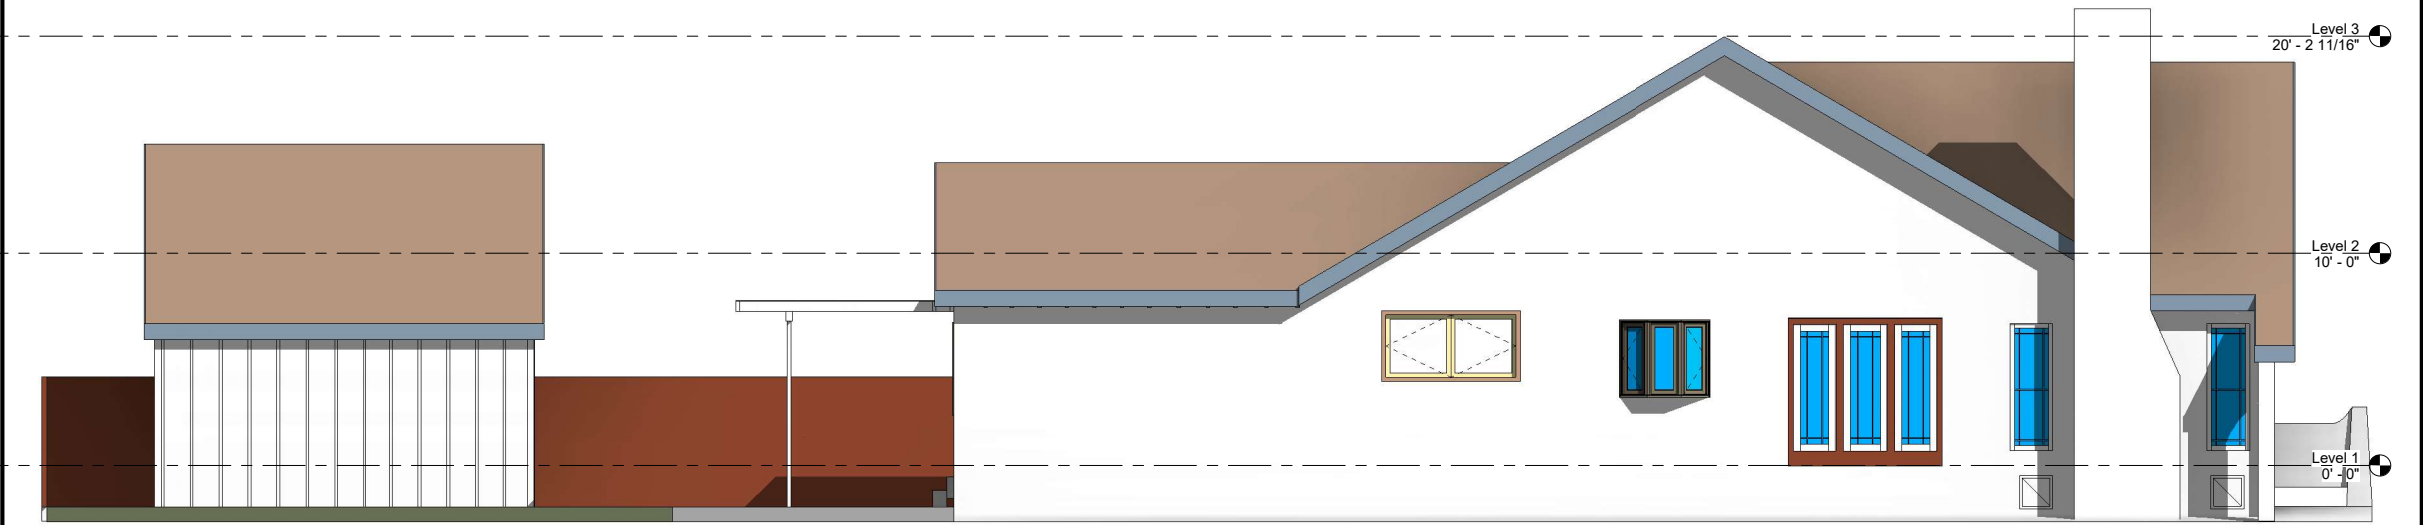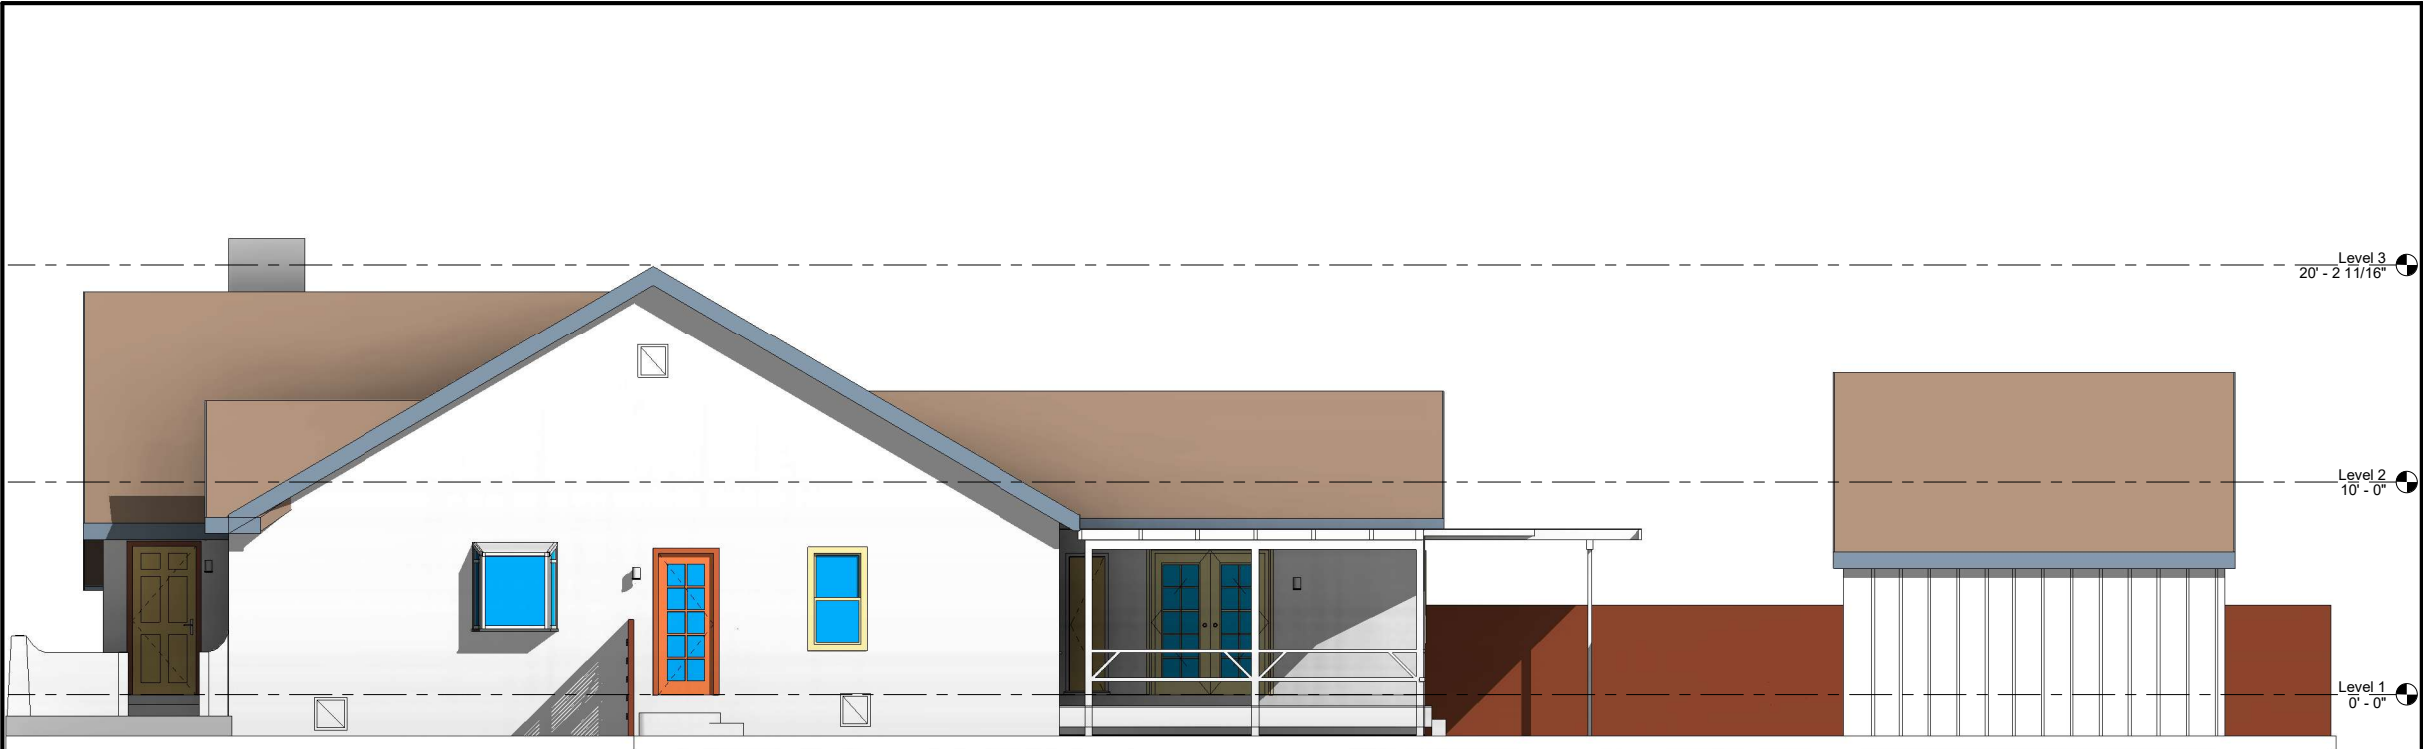

Project Owner:

Consultant:



2148 Gaviota Ave,  
Signal Hill, CA 90755  
(562) 507-3319  
varvizu@escaladesignsbuilt.com

Plans, maps, specifications, studies and reports not containing a red ink seal imprint accompanied by an original signature by the licensed professional may have been fraudulently altered and shall not be considered an original copy. All information should be disregarded unless verified by the professional whose signature appears below

Copyright protected 2022

Project Address:

2031 Pelham Ave

Stamp:

DATE	DESCRIPTION


Sheet Title:

EXTERIOR  
ELEVATION

DRAWN BY: Author
DRAWING DATE: 7.11.24
REVIEWED BY: VA
PROJECT NUMBER: Project Number
TEMPLATE TYPE:
SHEET

A7



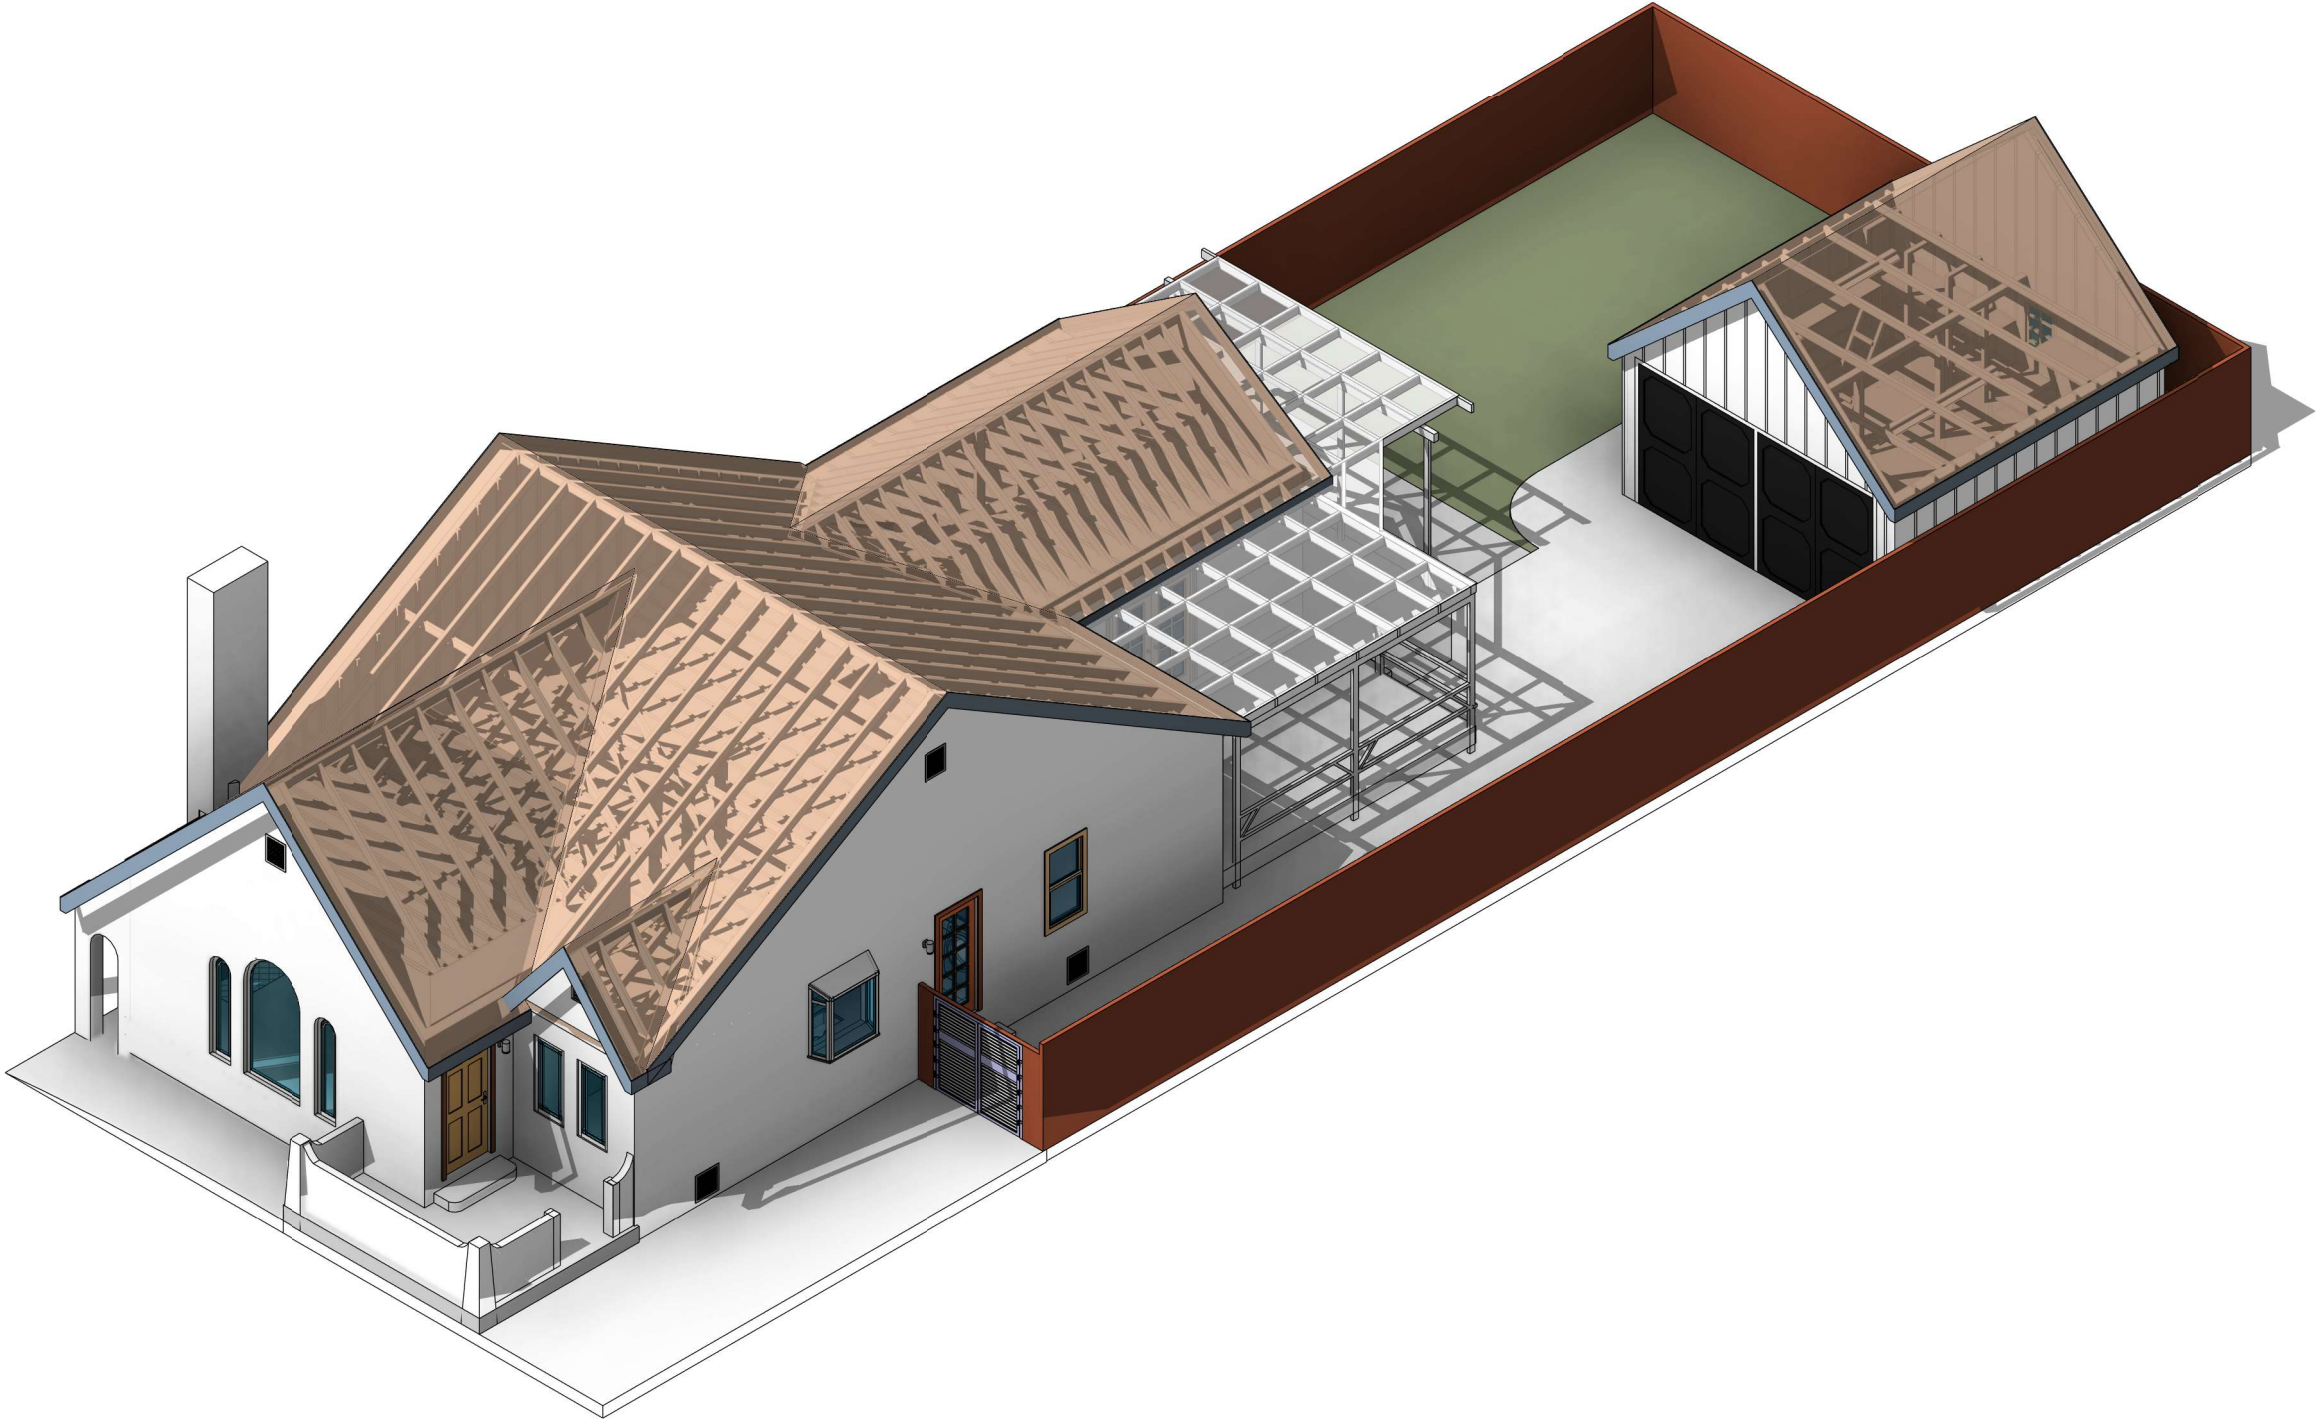

Project Owner:

Consultant:



2148 Gaviota Ave,  
Signal Hill, CA 90755  
(562) 507-3319  
varvizu@escaladesignsbuilt.com

Plans, maps, specifications, studies and reports not containing a red ink seal imprint accompanied by an original signature by the licensed professional may have been fraudulently altered and shall not be considered an original copy. All information should be disregarded unless verified by the professional whose signature appears below

Copyright protected 2022

Project Address:

2031 Pelham Ave

Stamp:

DATE	DESCRIPTION


Sheet Title:

3D  
VIEW

DRAWN BY: Author
DRAWING DATE: 7.11.24
REVIEWED BY: VA
PROJECT NUMBER:Project Number
TEMPLATE TYPE:
SHEET

A8



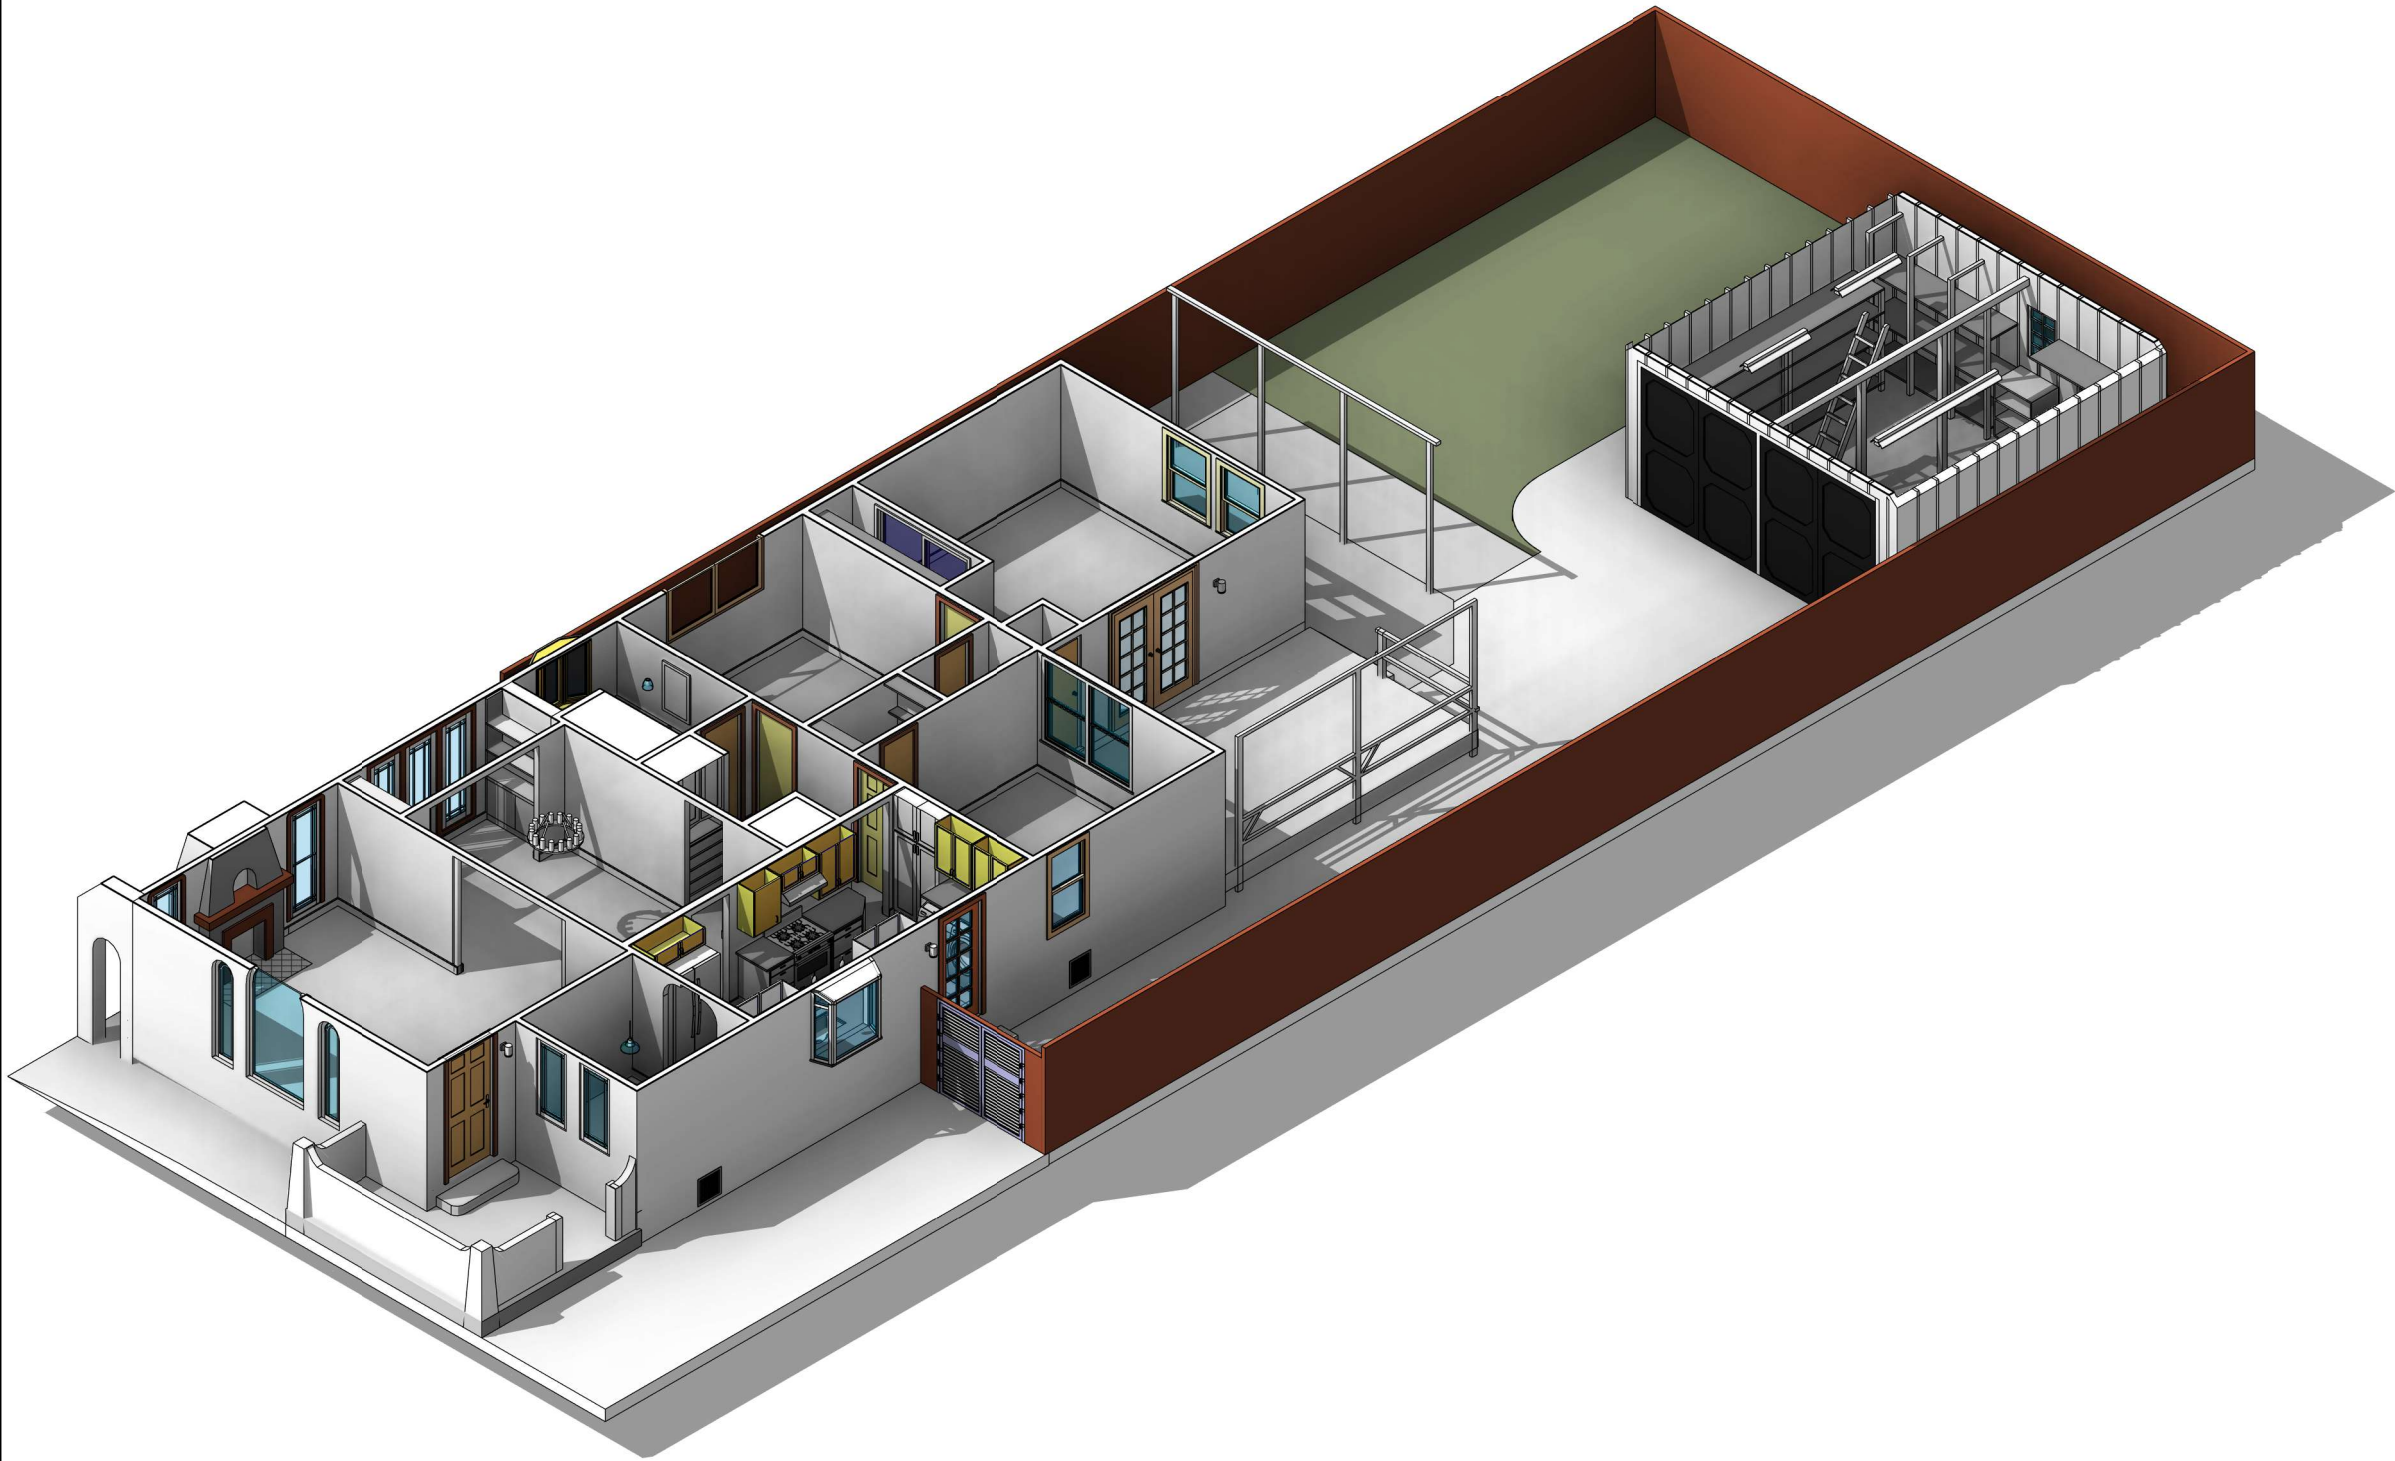

Project Owner:

Consultant:



2148 Gaviota Ave,  
Signal Hill, CA 90755  
(562) 507-3319  
varvizu@escaladesignsbuilt.com

Plans, maps, specifications, studies and reports not containing a red ink seal imprint accompanied by an original signature by the licensed professional may have been fraudulently altered and shall not be considered an original copy. All information should be disregarded unless verified by the professional whose signature appears below

Copyright protected 2022

Project Address:

2031 Pelham Ave

Stamp:

DATE	DESCRIPTION

Sheet Title:

3D  
PLAN  
VIEW

DRAWN BY: Author
DRAWING DATE: 7.11.24
REVIEWED BY: VA
PROJECT NUMBER:Project Number
TEMPLATE TYPE:
SHEET

A9